



**National Trust for
Historic Preservation**
Save the past. Enrich the future.

Addendum No. 2

PROJECT: SWIMMING POOL BUILDING MASONRY RESTORATION AT LYNDBURST

DATE: MARCH 17, 2026

RE: ADDENDUM NO. 2 TO REQUEST FOR PROPOSALS, ISSUED FEBRUARY 12, 2026

TO: ALL BIDDERS

DISTRIBUTION: VIA EMAIL TO PREBID WALKTHROUGH ATTENDEES / NTHP RFP WEBSITE

This addendum forms a part of the Contract Documents and modifies the original Bidding Documents dated February 12, 2026 and the First Addendum dated February 23, 2026, and shall be included in the relevant scopes of work and bids submitted. It is the bidder's responsibility to determine if their work is affected by this addendum. Failure to acknowledge receipt of this Addendum on bid submission may subject the Bidder to disqualification.

The Following is AMENDED:

GENERAL NOTES AND CLARIFICATIONS:

1. The bid deadline has been extended to **Friday, March 20, 5:00 P.M. EST.**
2. Responses to questions received from Contractors is attached.
3. The ramp and stair assembly on the East Elevation has been omitted from the Base Bid and is now an Add Alternate. The Bid Form has been revised to include the "Alternates" Section.

DRAWINGS:

1. SHEET A-101 FLOOR PLANS
 - a. Revise PLAN KEYNOTES as noted. New HM Door and Ramp/Stair assembly are now Alternate A-1.
2. SHEET A-401 ENLARGED PLAN AND ELEVATIONS - ADA RAMP AND STAIRS
 - a. Revise sheet as noted.
3. SHEET A-501
 - a. Issue sheet in its entirety.

SPECIFICATIONS:

1. SECTION 01 23 00 – ALTERNATES
 - a. Issue specification section in its entirety.

Attachments:

1. Q&A Document for Swimming Pool Building Masonry Restoration at Lyndhurst
2. Bid Form (Revised)
3. Pre-Bid Meeting Summary
4. Pre-Bid Sign-in Sheet

5. Drawing Sheets: A-101, A-401, A-501
6. Specification Sections: 01 23 -00 – ALTERNATES

END OF ADDENDUM NO. 2

RFP 2026-02 Q&A Document for Swimming Pool Building Masonry Restoration at Lyndhurst

Q1: Is the contractor required to maintain a Contractor's Professional Liability policy?

A: Yes. Per the RFP, Professional Liability coverage is required. Refer to the RFP for specific coverage requirements.

Q2: On Drawing MR-203, Detail 4 & 5, there is a H & B Stone Anchor shown to be utilized. Please specify a H & B Stone Anchor model number we are to use.

A: For balustrade and capstone anchors, assume HB#435-304-3/16 at typical stone-to-stone joints and HB#441-304-3/16 at end panels/coping stones.

Q3: Drawing A-302 is referenced but not included, please provide.

A: This was an error. There is no A-302 sheet. Detailed referring to A-302 should have referred to A-401. Refer to DRAWINGS section for revisions.

Q4: Drawing A-501 is missing from the set, please provide.

A: A-501 has been issued with Addendum 02.

Q5: The RFP is missing cast stone specification for the new cast stone, please provide.

A: Cast stone design mix and reinforcement shall be determined by the contractor and/or cast stone fabricator to match the existing cast stone balustrade. Contractor to provide samples to the Owner/Architect for selection and verification.

Cast stone shall follow standard requirements and specifications of the Cast Stone Institute and be warranted for a period of no less than 10-years by manufacturer against defects in materials and manufacturing.

Q6: The RFP is missing the roofing specification, please provide.

A: Roofing is not part of this project scope and will be issued by separate RFP. Where roofing work and masonry work overlap at the balustrade, the roofing contractor will be responsible for surface prep of the roofing substrate prior to anchor and balustrade installation. The roofing contractor will apply necessary drainage improvements over the existing roof substrate and then install the fluid-applied roofing membrane after Masonry Contractor has completed balustrade reconstruction.

Exhibit B

BID FORM

(Revised March 16, 2026 via Addendum 2)

PROJECT: Swimming Pool Building Masonry Restoration at Lyndhurst - Tarrytown, New York

TO: Elaine Chang, Associate Manager
National Trust for Historic Preservation
600 14th Street NW, Suite 500
Washington, DC 20005

FROM:

(Bidder Name)

(Address)

(City, State, Zip)

Pursuant to notices given, the undersigned proposes to furnish all material and labor, and perform all work necessary to complete masonry restoration of the Swimming Pool Building at the Lyndhurst Historic Site in Tarrytown, New York, in accordance with details and requirements contained within the Request for Proposal prepared by the National Trust for Historic Preservation and its consultants, and all Addenda acknowledged herein:

1. BIDDER'S CERTIFICATION

The undersigned Bidder certifies that he/she has examined and fully comprehends the bidding requirements, the Conditions of the Contract, and the requirements and intent of The Bidding Documents.

The undersigned Bidder certifies that he/she has visited the site(s) and examined all conditions affecting the Work.

The undersigned Bidder certifies that applicable federal and Massachusetts state taxes are excluded in the Base Bid.

2. ADDENDA

The undersigned Bidder acknowledges receipt of the following Addenda:

Addendum No. _____ Dated _____

Addendum No. _____ Dated _____

Addendum No. _____ Dated _____

4. **BASE BID FOR GENERAL CONSTRUCTION** – Swimming Pool Building Masonry Restoration at Lyndhurst Historic Site

Item	Description	Lump Sum Bid (Numerals)
Base Bid No. 1	South Elevation	\$ _____
Base Bid No. 2	West Elevation	\$ _____
Base Bid No. 3	East Elevation (incl. stairs & ramp)	\$ _____
Base Bid No. 4	North Elevation	\$ _____

TOTAL BASE BID: _____ Dollars
(Written Amount)

(\$ _____) (Numerals)

5. **ALTERNATES** (Refer to Specification Section 01 23 00 – Alternates)

a). Alternate A-1: Entrance Door and Stair and Accessible Ramp Assembly \$ _____

6. **UNIT PRICES FOR THE WORK** (Refer to Specification Section 01 22 00 – Unit Prices for complete descriptions of each Unit Price)

Unit Price 1: Brick Unit Replacement \$ _____ Per Unit

Unit Price 2: Cast Stone Partial or Full Replacement \$ _____ Per SF

Unit Price 3: Cast Stone Crack Repair \$ _____ Per LF

Unit Price 4: Steel Lintel Replacement \$ _____ Per Unit

7. **BONDING REQUIREMENTS**

Bid Bond/Guarantee: Provided? (Y/N) _____ Sum \$ _____

Performance Bond: Provided? (Y/N) _____ Sum \$ _____

Payment Bond: Provided? (Y/N) _____ Sum \$ _____

8. MWBE PARTICIPATION

Total percentages of participation (based on Base Bid):

MBEs: _____ % WBEs: _____ %

9. ACKNOWLEDGMENT

The undersigned Bidder understands that the Owner reserves the right to reject this bid, and that this bid shall remain open and shall not be withdrawn for a period of ninety (90) calendar days from the date prescribed for its opening.

10. TIME OF COMPLETION

If awarded this Contract, the undersigned Bidder acknowledges that work of the Base Bid shall commence and be completed, including all punch list items, in accordance with the Contract Documents.

10. TAX EXEMPTION

The undersigned Bidder has informed themselves and all their prospective subcontractors and suppliers of the tax-exempt status of the Owner and therefore has not included these taxes in their Base Bid price.

11. SUBSTITUTIONS

The undersigned Bidder has based their bid upon the materials, products, articles, equipment, brands, manufacturers and processes described in the Bidding Documents or upon approved equivalents. Proof of equivalency of substitutions is the responsibility of the Bidder, but the Owner shall be the sole judge of equivalency. Proposed equivalent substitutions shall be equal in all respects to the requirements of the Bidding Documents, including but not limited to the design, quality, physical size, performance characteristics, strength, previous history of use, and to the method of installation, attachment, or connection to related or adjoining work. Determination of equivalency of proposed substitutions shall be made by the Project Manager before the bid opening date. Any substitutions proposed after the Bid shall be rejected unless otherwise formally proposed by the Bidder and accepted by the Project Manager in writing.

12. SIGNATURES

In testimony whereof, the Bidder has caused this proposal to be signed by its authorized representative this _____ day of _____, 2026.

Signatures:

By: _____

Title: _____



Pre-Bid Meeting Summary

PROJECT NAME: SWIMMING POOL BUILDING EXTERIOR MASONRY RESTORATION

PROJECT LOCATION: LYNDHURST, TARRYTOWN, NEW YORK

DATE/TIME: MARCH 4, 2026 10:00 A.M. ET

1. Call to Order & Introductions

- a. Sign-in Form
- b. Introductions
 - i.) Owner: National Trust for Historic Preservation
 - ii.) Architect: Mark Stoner, AIA NCARB
NTHP Senior Director of Preservation Architecture
 - iii.) Project Coordinator: Krystyn Hastings-Silver
Lyndhurst Assistant Director
 - iv.) Other Project Rep: David Ware, Lyndhurst Buildings & Grounds Manager
Howard Zar, Lyndhurst Executive Director
 - v.) Consultants: Leverett Masonry Consultants (Chicago, IL)
Russel Watsky Roofing Consultant
 - vi.) NTHP Legal Reps: Katheleen Mannard, NTHP Associate General Counsel
Elaine Chang, NTHP Associate Manager

2. Project Introduction and Scope of Work

- a. Building Information
 - i.) Lyndhurst Estate
 - a. Built 1838, Expanded 1865
 - b. Bequeathed to the National Trust for Historic Preservation in 1961 and opened as a museum and historic site in 1965
 - c. 14 buildings on 67 acres owned and operated by the National Trust
 - ii.) Swimming Pool Building
 - a. Built in 1911 as both a private and public amenity for recreation and to teach local children how to swim
 - b. Originally featured a Classical Greco-Roman Revival interior and a glass roof with decorative clerestory windows
 - c. National Trust completed stabilization efforts in 1980s, including limited masonry repairs, removal of the cast stone balustrade, and replacement of the glass roof with a temporary corrugated metal roof
 - d. National Trust was awarded a Saving America's Treasures Grant from the National Park Service to complete the exterior restoration of the building.
- b. Scope of Work
 - i.) Full repointing and cleaning; refer to the masonry specification for mortar mix based on our historic masonry consultant
 - ii.) Brick replacement with new brick to match the existing brick
 - iii.) Installation of masonry reinforcement
 - iv.) Partial repair or replacement of cast stone units
 - v.) Reconstruction of the stone entablature on the front elevation
 - vi.) Treatment of existing lintels and replacement of damaged lintels
 - vii.) Installation of new cap flashing above existing stone copings
 - viii.) New door opening on the northeast side of the building with a new stair and

- ramp assembly
 - ix.) Refer to drawings and specifications for full detailed scope of work
 - c. Anticipated Project Schedule:

Final contract award decision	March 30, 2026
Contract fully executed	April 17, 2026
<i>(*Note: All contracts require NPS review and approval)</i>	
Mobilization Period	April 20-May 8, 2026
Start of Construction	May 11, 2026
Substantial Completion	August 21, 2026
 - d. Additional Scope Notes
 - i.) Note all mock-up requirements in drawings and specifications
 - ii.) Note that bid form breaks up project by Elevation. Owner intends to complete the project in its entirety.
 - iii.) Addendum forthcoming to make door opening and stair/ramp assembly an Alternate
 - iv.) Contractor is responsible for obtaining all required permits. Owner is responsible for securing ARB approval.
 - v.) Roof restoration work – including repairs and existing corrugated roofing and new roofing around balustrade area – will be completed concurrently with masonry restoration work by separate contract. Owner to coordinate overlapping work between contractors.
 - vi.) Window and exterior door restoration scope may be completed concurrently during latter portion of masonry restoration work.
 - vii.) RFP for the roofing work will be released in the next few weeks
 - viii.) RFP for windows and exterior doors will be released in the Spring once the final budget for the masonry and roof work has been determined.

3. Bidding and Procurement Requirements

- a. Refer to RFP for submission requirements, including required information, bid form, formatting, criteria for selection, and other requirements.
- b. Must include completed Certification Regarding Debarment and Suspension included in RFP document with bid submission
- c. Bonding Requirements (Federal requirement of grant):
 - i.) **Bid Bond/Guarantee:** Submit bond or certified check for 5% of the bid amount. Submit photocopy with digital bid proposal and mail or deliver physical bond/check to Krystyn Hastings-Silver at Lyndhurst.
 - ii.) **Performance Bond:** Submit letter from surety guaranteeing bond coverage; including cost of bond on Bid Form; it is assumed that bond value will be added to the Bid Amount to determine the total Contract Sum.
 - iii.) **Payment Bond:** Submit letter from surety guaranteeing bond coverage; including cost of bond on Bid Form; it is assumed that bond value will be added to the Bid Amount to determine the total Contract Sum.
 - iv.) After selecting contractor, NTHP intends to submit a request to NPS to remove Performance and Payment Bond requirements; may require financial statements from the selected contractor to void the requirements
- d. Note Unit Prices on bid form and detailed in specifications.
- e. The National Trust for Historic Preservation is a tax-exempt organization; tax-exempt certificate will be provided to the awarded contractor
- f. No Prevailing Wage/Davis-Bacon requirement for this project
- g. Refer to the front end specifications for all procedural requirements, including substitution procedures, submittals, historic treatment procedures, temporary facilities, and execution and closeout requirements.
- h. Procurement Schedule:

Last Day to submit questions or comments	March 9, 2026 (Monday)
Final RFP Addendum Issued (as needed)	March 13, 2026 (Friday)
Proposals Due	March 19, 2026 (Thursday, 5pm)
Proposal evaluation period	March 20-April 10, 2026
Interviews (as needed)	March 25-26, 2026
Final contract award decision	March 30, 2026

4. Supplementary Terms and Conditions

- a. Refer to Exhibit D in the RFP for specific terms and conditions
- b. Page 17 of the RFP defines minimum insurance requirements for contractors; ensure that the COI included with the bid submission meets these coverage requirements
- c. Refer to the Exhibit D for specific state and federal procurement and work requirements of this project, including the Equal Opportunity Clause, the Copeland Anti-Kickback Act, Contract Work Hours and Safety Standards Act, "Build Amera, Buy America", and other regulatory requirements.
- d. Site access and operations:
 - i.) Lyndhurst Historic Site will be open and operational during the duration of work.
 - ii.) North Gate House is a rental residence and will be occupied during the duration of the work. Work hours must be strictly adhered to except as otherwise agreed to in writing.
 - iii.) Site access, laydown areas, and dumpster locations will be coordinated with Krystyn Hastings-Silver and David Ware

5. Site/Building Walkthrough



Pre-Bid Sign-in Sheet


PROJECT: LYNDHURST SWIMMING POOL BUILDING MASONRY RESTORATION

DATE: MARCH 4, 2026


TIME: 10:00 AM ET

LOCATION: LYNDHURST SWIMMING POOL BUILDING (JOB SITE)

Name	Company	Title	Email Address
Mark Stoner	National Trust for Historic Preservation	Senior Director of Preservation Architecture	mstoner@savingplaces.org
Krystyn Hastings-Silver	Lyndhurst/NTHP	Assistant Director	ksilver@savingplaces.org
David Ware	Lyndhurst/NTHP	Buildings and Grounds Manager	dware@savingplaces.org
Sal Santopietro	G.L. Capasso	Supervisor	sal@glcapasso.com
Davie Carino	TJR Excavating Contractors inc	Vice President	tjrexexcavation@gmail.com
Edward J. Napoleon	Abbott & Price, inc.	President	enapoleon@abbottprice.com
Michael O'Neill	Frank Capasso & Sons, Inc.	Estimator	mo@frankcapassoandsons.com

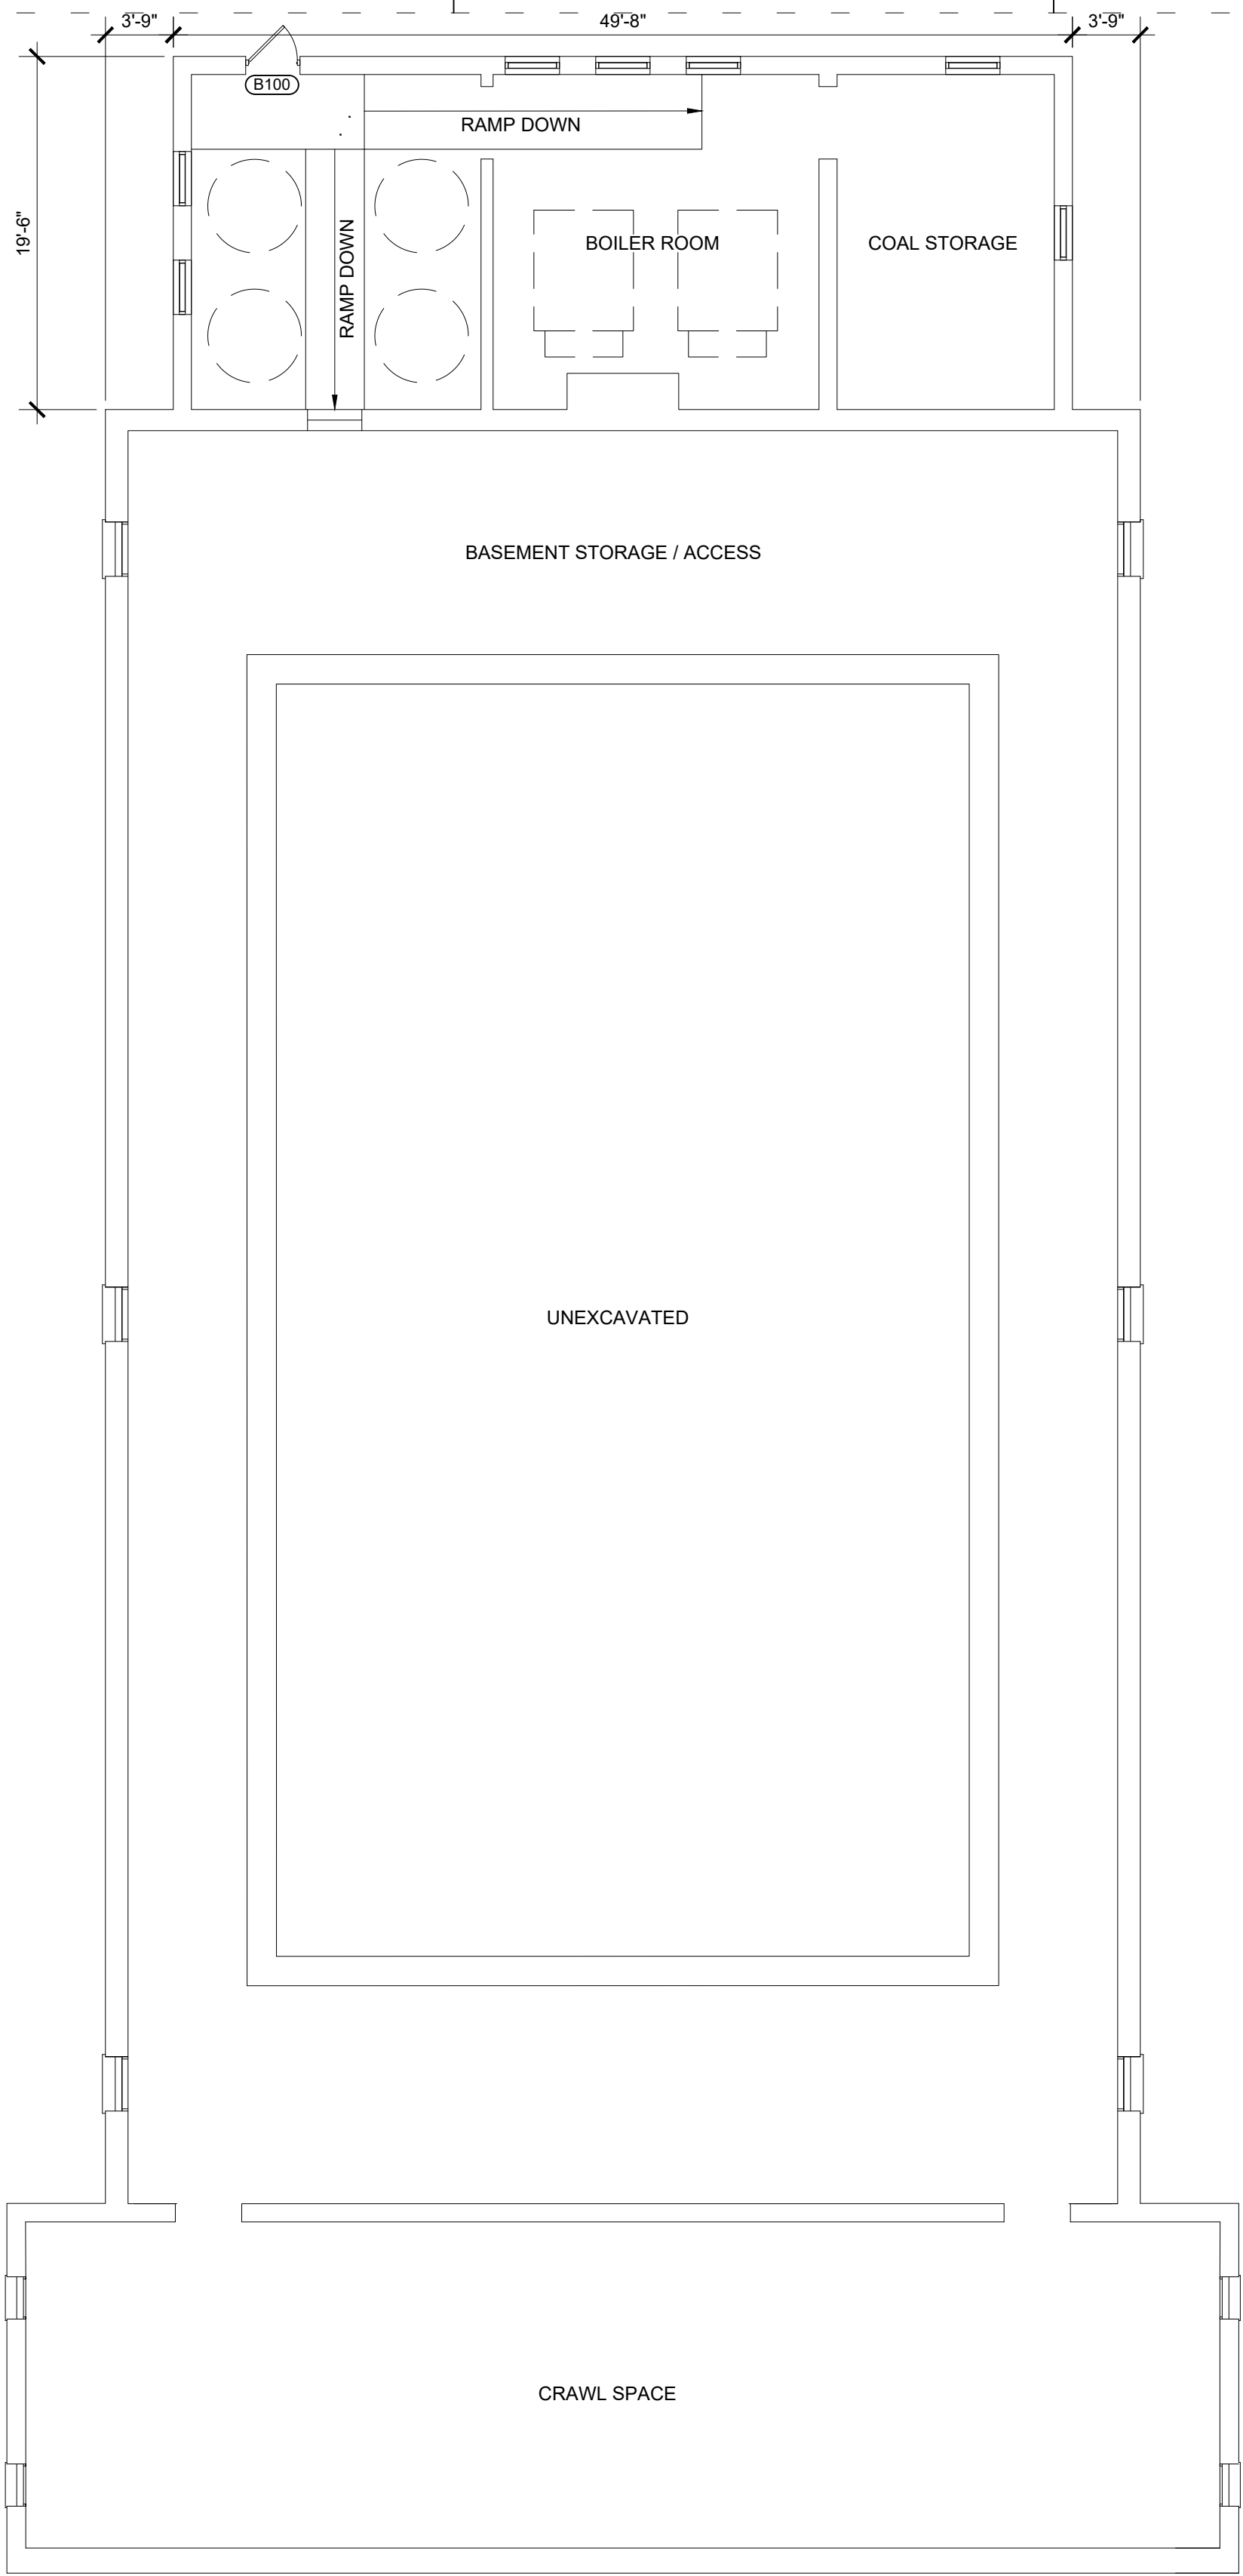

BASEMENT/CRAWL SPACE PLAN
Scale: 1/8" = 1'-0"

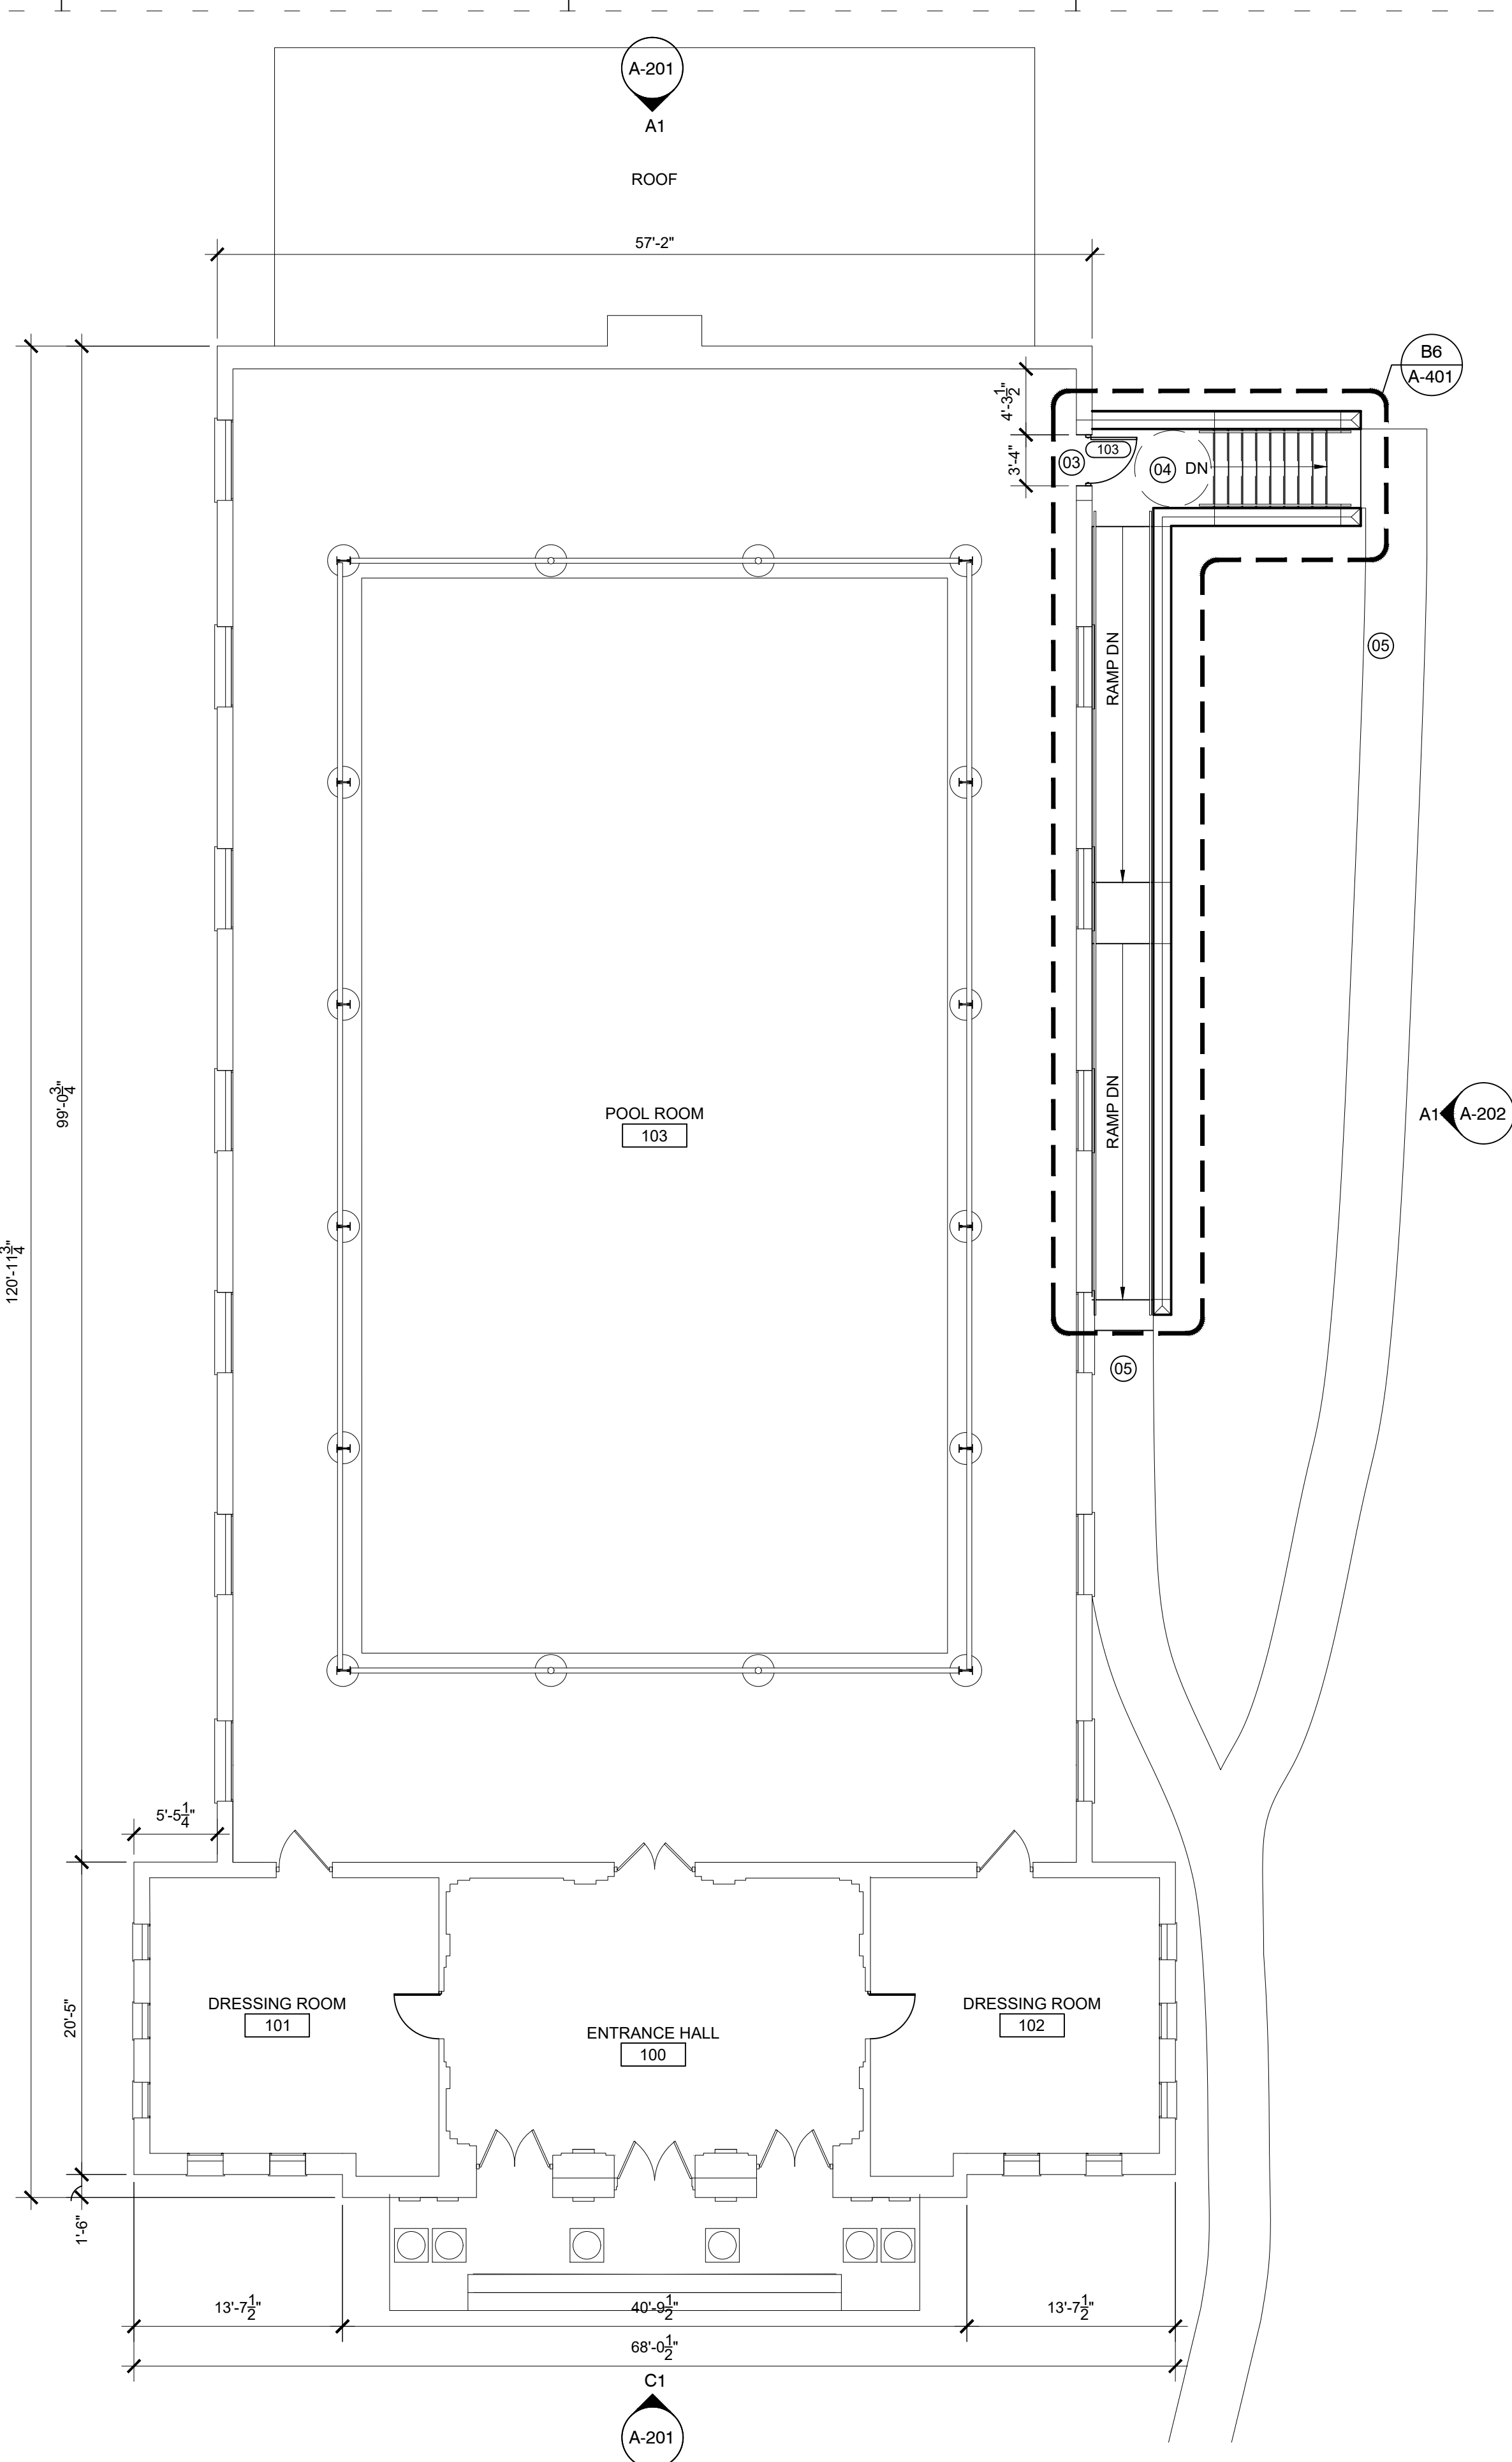

GROUND FLOOR PLAN
Scale: 1/8" = 1'-0"

GENERAL ARCH. NOTES

- 01 THESE GENERAL NOTES APPLY TO ARCHITECTURAL DRAWINGS.
- 02 WORK SHOWN ON THE DRAWINGS SHALL BE BASE BID UNLESS SPECIFICALLY NOTED TO BE BY ALTERNATE BID.
- 03 DO NOT SCALE DRAWINGS. EXISTING DIMENSIONS ARE SHOWN FOR REFERENCE ONLY AND SHALL BE FIELD VERIFIED BY THE CONTRACTOR. REFER DIMENSION QUESTIONS TO ARCHITECT FOR INTERPRETATION.
- 04 PROTECT EXISTING SURFACES TO REMAIN THAT ARE NOT INCLUDED IN SCOPE OF WORK BUT THAT ARE WITHIN AREAS OF CONSTRUCTION ACTIVITY.
- 05 DOOR AND FRAME NUMBERS CORRESPOND TO RESPECTIVE ROOM NUMBERS. IN ROOM WITH MULTIPLE OPENINGS, A SUFFIX HAS BEEN ADDED TO DOOR NUMBERS, E.G. 102A. PATCH, REPAIR, AND RESTORE EXISTING FINISHES AND SURFACES TO "AS NEW CONDITION" AS REQUIRED TO MATCH SURROUNDING MATERIALS OR TO PROVIDE APPROPRIATE SUBSTRATE PRIOR TO INSTALLING NEW FINISHES. AREAS NOTED TO BE PATCHED OR REPAIRED ON THE DRAWINGS ARE GIVEN FOR REFERENCE AND SHALL NOT BE INTERPRETED TO LIMIT THE SCOPE OF WORK.
- 07 DO NOT BEGIN WORK THAT MAY REQUIRE COORDINATION, SUCH AS CEILING INSTALLATION, PRIOR TO FINAL SUBMITTAL OF EQUIPMENT (E.G. MECHANICAL AND ELECTRICAL SYSTEMS, IF RELEVANT) COORDINATION DRAWINGS TO ARCHITECT NOR PRIOR TO RESOLUTION AND APPROVAL OF COORDINATION ISSUES.

PLAN KEYNOTES

- 01 NOT USED
- 02 NOT USED
- 03 NEW HM DOOR AND FRAME IN NEW MASONRY OPENING. REFER TO DOOR SCHEDULE FOR ADDITIONAL INFORMATION. SALVAGE REMOVED BRICK FOR REUSE. (ALTERNATE A-1)
- 04 NEW ADA-COMPLIANT MASONRY AND CAST-IN-PLACE CONCRETE RAMP AND STAIR ASSEMBLY WITH PAINTED METAL HANDRAILS. REFER TO ENLARGED PLAN, ELEVATIONS, AND DETAILS. (ALTERNATE A-1)
- 05 NEW CONCRETE WALKWAY, BY OTHERS (NIC).

*INTERIOR FLOORPLANS SHOWN FOR REFERENCE ONLY. NO WORK IN THIS AREA, EXCEPT AS NECESSARY TO COMPLETE THE IDENTIFIED SCOPE OF WORK.



National Trust for Historic Preservation

PROJECT
Swimming Pool Building
Exterior Restoration
Lyndhurst
Tarrytown, NY

Owner
The National Trust for Historic Preservation
600 14th Street NW Suite 500
Washington, DC 20005

Mark Stoner, AIA NCARB
Senior Director of Preservation Architecture
(202) 588-6183

Masonry Consultant
Leverett Masonry Consulting
658 51st Street STE 3E
Chicago, IL 60615
(312) 459-0625

Roofing Consultant
Russel Watsky, Inc.
21 Hawkes Avenue
Ossining, NY 10562
(914) 941-4604

SEAL | DATE



SHEET ISSUE	
ISSUED FOR BID	01/01/26
ADDENDUM 02	03/16/26

DRAWN BY: MDS PROJ. NO.:

APPROVED BY: MDS

SHEET TITLE
FLOOR PLANS

SHEET NO.

A-101



National Trust for Historic Preservation

PROJECT

Swimming Pool Building
Exterior Restoration
Lyndhurst
Tarrytown, NY

Owner

The National Trust for Historic Preservation

600 14th Street NW Suite 500
Washington, DC 20005

Mark Stoner, AIA NCARB
Senior Director of Preservation Architecture
(202) 588-6183

Masonry Consultant

Leverett Masonry Consulting

658 51st Street STE 3E
Chicago, IL 60615
(312) 459-0625

Roofing Consultant

Russel Watsky, Inc.

21 Hawkes Avenue
Ossining, NY 10562
(914) 941-4604

SEAL | DATE



SHEET ISSUE

ISSUED FOR BID	01/01/26
ADDENDUM 02	03/16/26

DRAWN BY: MDS

PROJ. NO.:


APPROVED BY: MDS

SHEET TITLE

ENLARGED PLAN AND
ELEVATIONS
ADA RAMP AND STAIRS

SHEET NO.

A-401

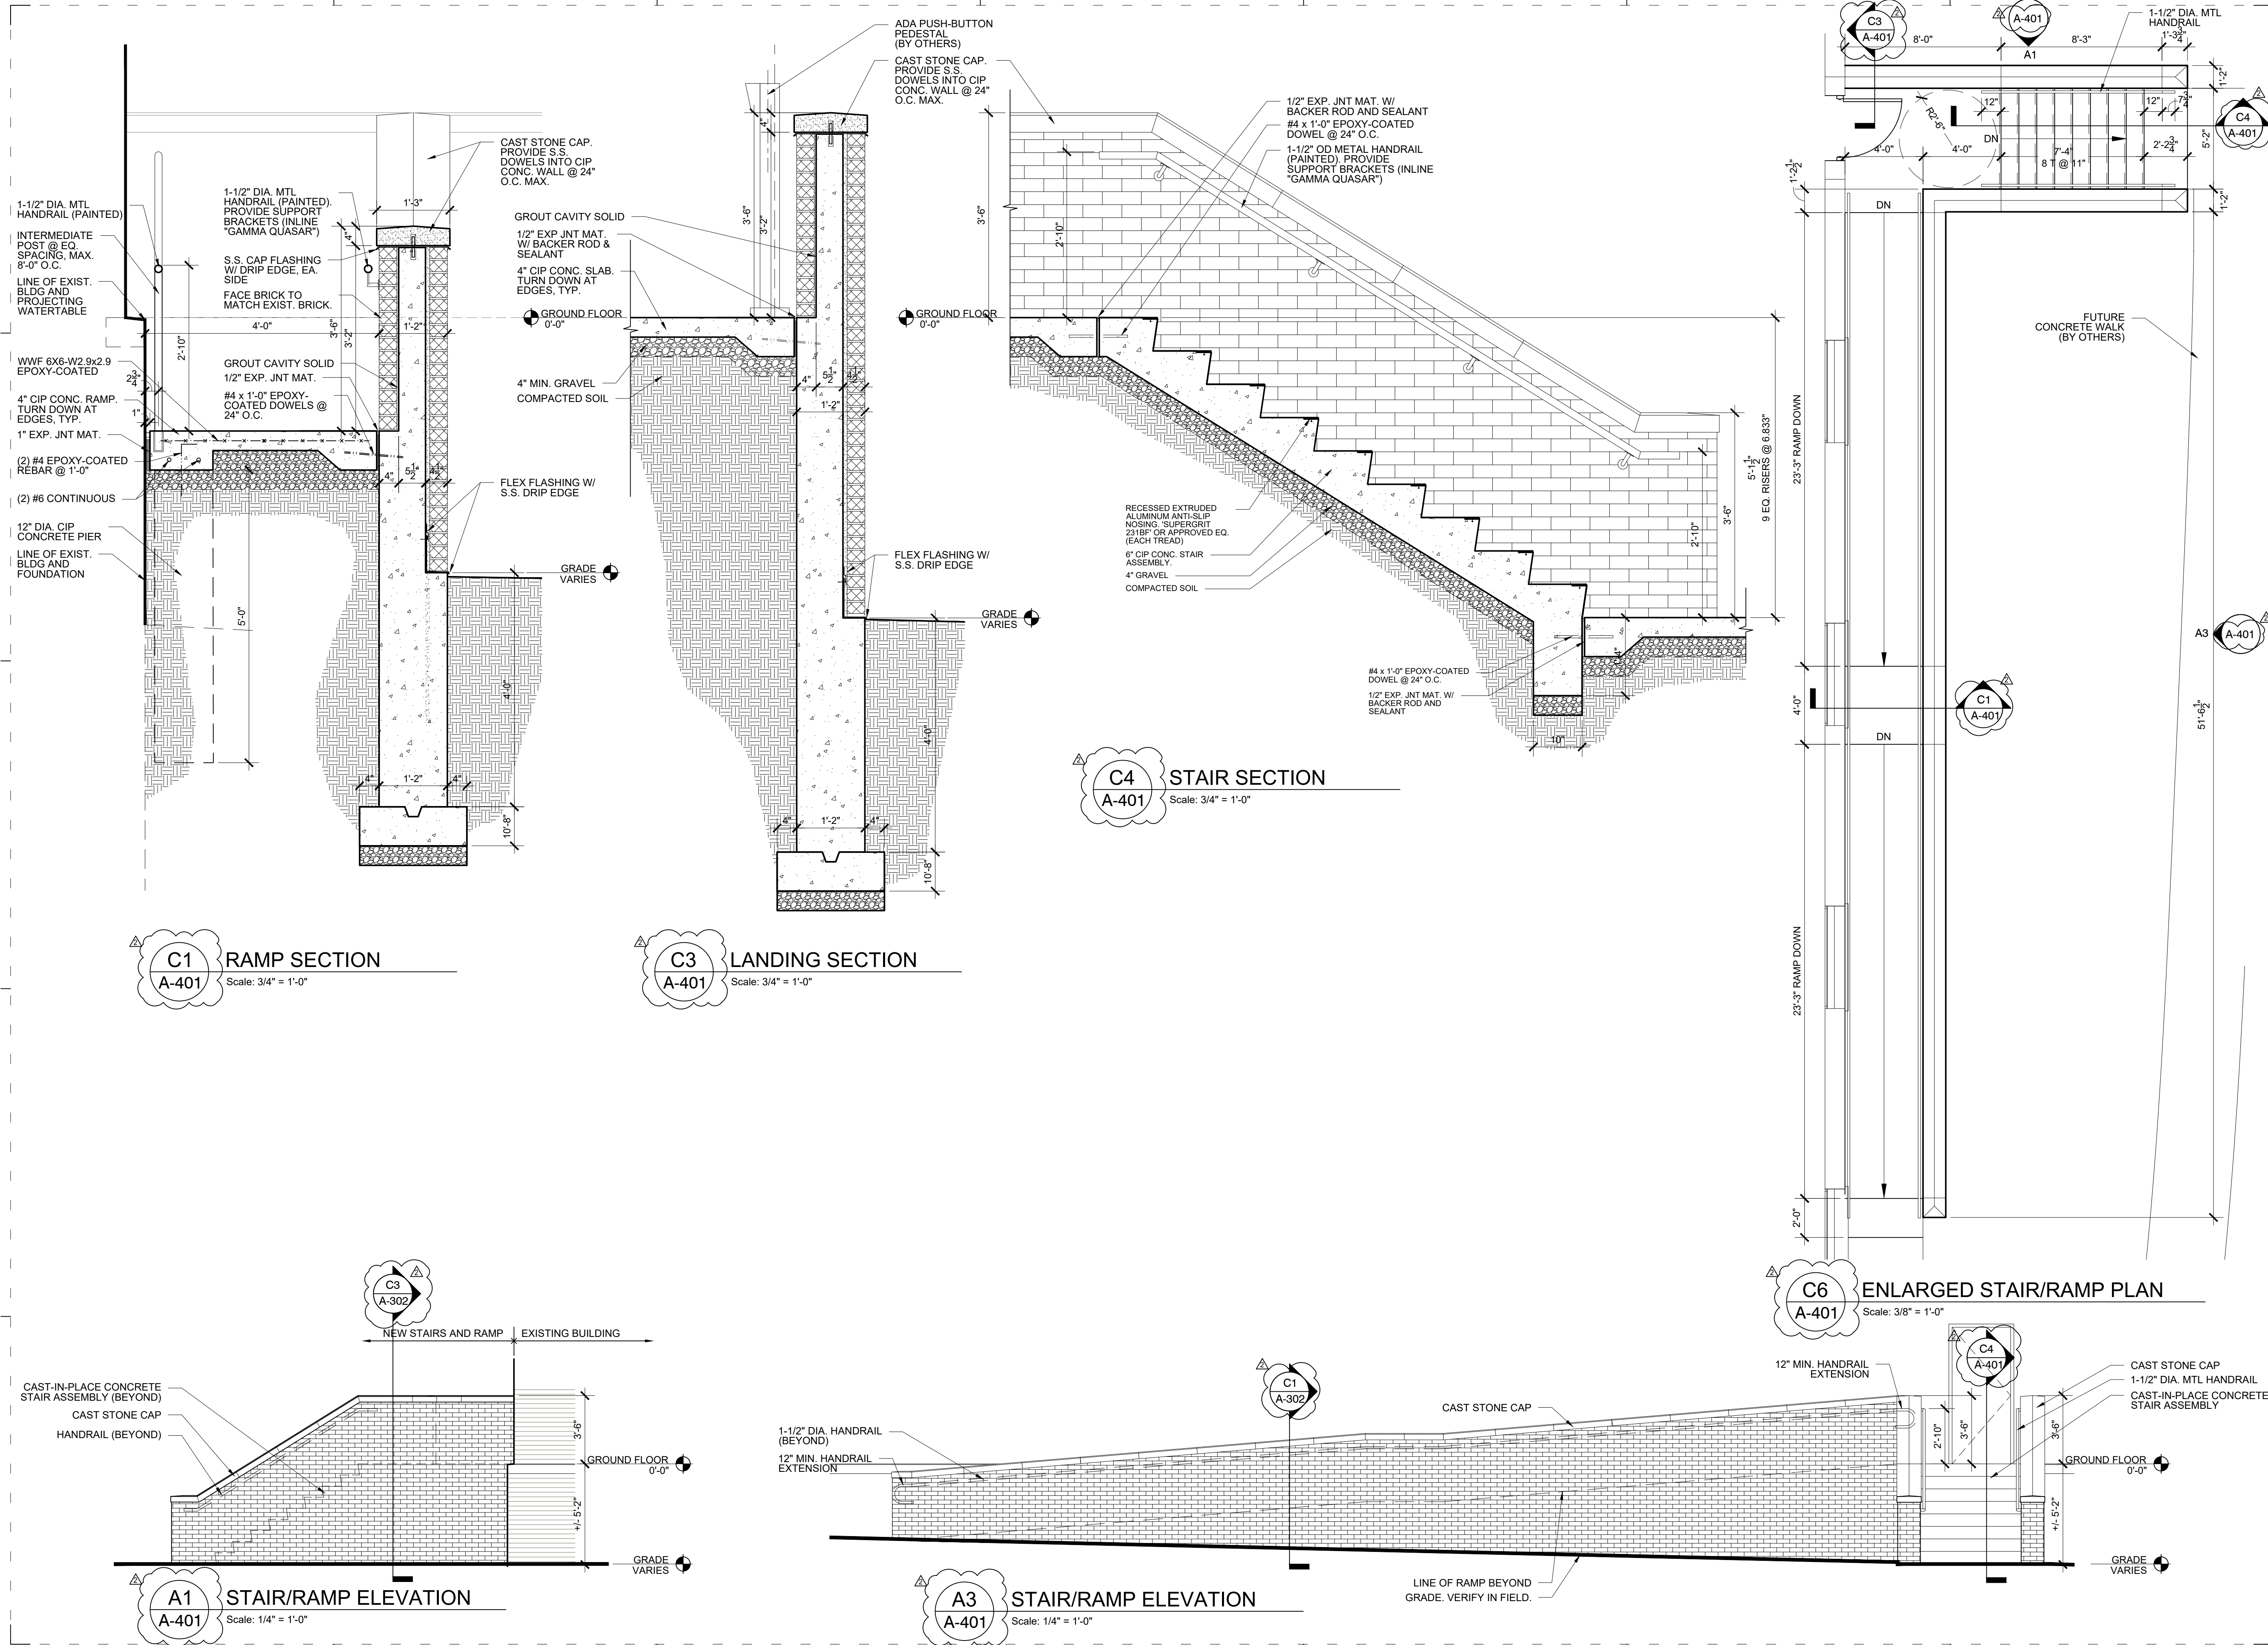

Hardware Set No. 2

For use on mark/door #(s):
103

Qty		Description	Catalog Number	Finish	Mfr
1	EA	CONT. HINGE	112HD	313AN	IVE
1	EA	PANIC HARDWARE	25-C-C-718	613	FAL
1	EA	PANIC HARDWARE	25-C-EO	613	FAL
1	EA	RM HOUSING	C953	613	FAL
1	EA	SFIC CORE	C607 SFIC RES	613	FAL
1	EA	90 DEG OFFSET PULL	8190HD 10" O	613	IVE
1	EA	SURFACE CLOSER	SC71A SS	695	FAL
1	EA	WEATHERSTRIP	BY DOOR MANUFACTURER		B/O
1	EA	DOOR SWEEP W/ DRIP	8198D	D	ZER
1	EA	THRESHOLD, 1/2" SADDLE (W/ TB)	625A	A	ZER


DOOR SCHEDULE

DOOR NUMBER	PAIR	DOOR							FRAME					FIRE RATING	REMARKS	
		SIZE			MTRL.	ELEV.	GLASS	HDWR. SET	MTRL.	ELEV.	HEAD	JAMB	THRESHOLD			
W	H	T														
100A					EXISTING DOOR											
100B					EXISTING DOOR											1, 2, 3, 4
100C					EXISTING DOOR											1, 2, 3, 4
101A		3'-0"	6'-8"	1-3/4"	WD	D1	-	1								
102A		3'-0"	6'-8"	1-3/4"	WD	D1	-	1								
102B	Y				EXISTING DOORS											5
103		3'-0"	7'-0"	1-3/4"	WD	D2	-	2	HM	F1	H1	-	-	90 MIN		

* FIELD VERIFY ALL EXISTING WALL OPENING DIMENSIONS PRIOR TO DOOR FABRICATION


REMARKS:

1. REMOVE AND REPLACE ALL EXTERIOR WEATHERSTRIPPING AND SEALANTS AS REQUIRED TO ENSURE SEALED ENVELOPE.
2. SCRAPE AND REPAINT EXISTING WOOD DOOR AND FRAME.
3. REPLACE ANY BROKEN GLAZING WITH NEW CLEAR TEMPERED GLASS.
4. REPAIR EXISTING HARDWARE TO ENSURE PROPER FUNCTION.
5. REINSTALL EXISTING DOOR(S) IN EXISTING FRAME. REPAIR DOOR AND HARDWARE REQUIRED TO ENSURE PROPER FUNCTION.

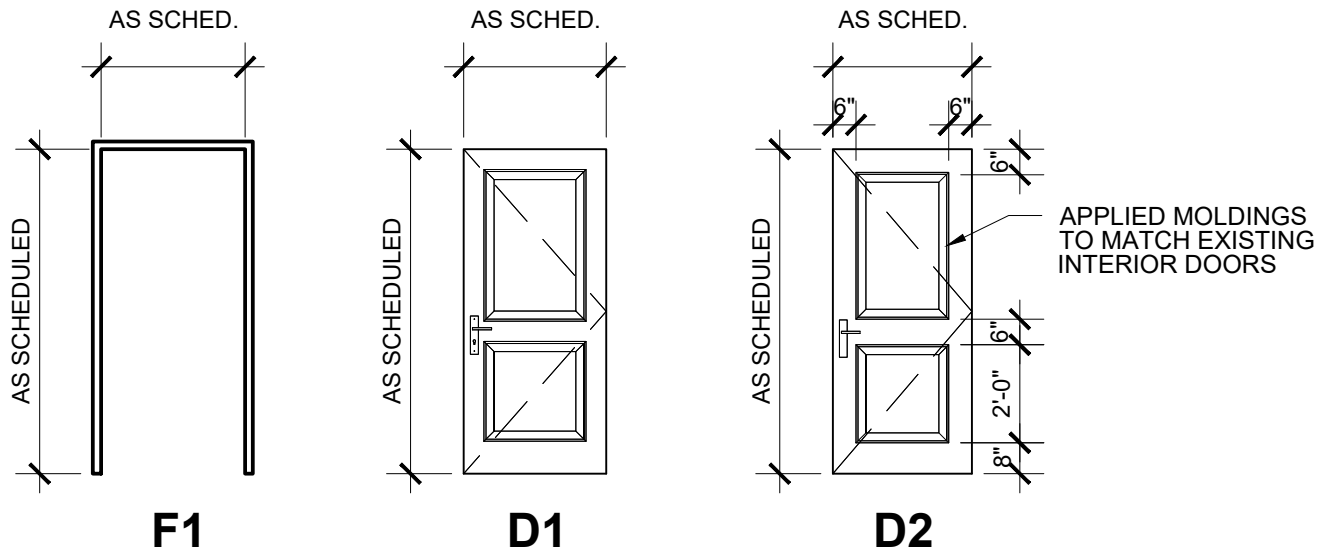

DOOR AND FRAME ELEVATIONS

Scale: 1/4" = 1'-0"

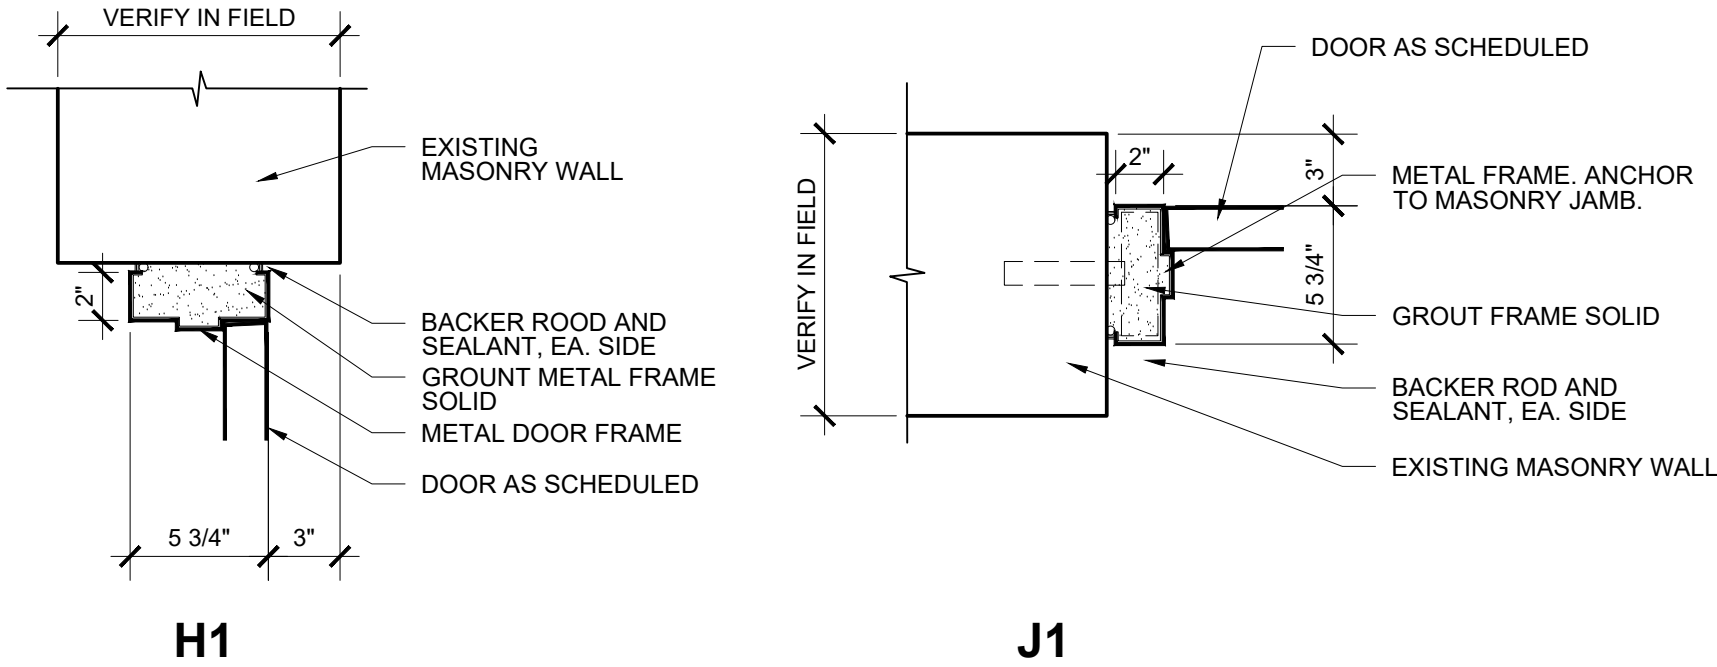

DOOR HEAD & JAMB DETAILS

Scale: 1 1/2" = 1'-0"



National Trust for
Historic Preservation

PROJECT

Swimming Pool Building
Exterior Restoration
Lyndhurst
Tarrytown, NY

Owner

The National Trust for
Historic Preservation

600 14th Street NW Suite 500
Washington, DC 20005

Mark Stoner, AIA NCARB
Senior Director of Preservation Architecture
(202) 588-6183

Masonry Consultant

Leverett Masonry Consulting

658 51st Street STE 3E
Chicago, IL 60615
(312) 459-0625

Roofing Consultant

Russel Watsky, Inc.

21 Hawkes Avenue
Ossining, NY 10562
(914) 941-4604

SEAL | DATE



SHEET ISSUE

ISSUED FOR BID	01/01/25
ADDENDUM 02	03/16/26

DRAWN BY:

PROJ. NO.:

APPROVED BY:

SHEET TITLE

DOOR SCHEDULE AND
DETAILS

SHEET NO.

A-501

SECTION 01 23 00

ALTERNATES

PART 1 GENERAL

1.01 SUMMARY

- A. Section includes administrative and procedural requirements for alternates.

1.02 DEFINITIONS

- A. Alternate: An amount proposed by bidders and stated on the Bid Form for certain work defined in the bidding requirements that may be added to or deducted from the base bid amount if Owner decides to accept a corresponding change either in the amount of construction to be completed or in the products, materials, equipment, systems, or installation methods described in the Contract Documents.
 - 1. Alternates described in this Section are part of the Work only if enumerated in the Agreement.
 - 2. The cost or credit for each alternate is the net addition to or deduction from the Contract Sum to incorporate alternate into the Work. No other adjustments are made to the Contract Sum.

1.03 PROCEDURES

- A. Coordination: Revise or adjust affected adjacent work as necessary to completely integrate work of the alternate into Project.
 - 1. Include as part of each alternate, miscellaneous devices, accessory objects, and similar items incidental to or required for a complete installation whether or not indicated as part of alternate.
- B. Notification: Immediately following award of the Contract, notify each party involved, in writing, of the status of each alternate. Indicate if alternates have been accepted, rejected, or deferred for later consideration. Include a complete description of negotiated revisions to alternates.
- C. Execute accepted alternates under the same conditions as other work of the Contract.
- D. Schedule: A schedule of alternates is included at the end of this Section. Specification Sections referenced in schedule contain requirements for materials necessary to achieve the work described under each alternate.

PART 2 PRODUCTS - NOT USED

PART 3 EXECUTION

3.01 SCHEDULE OF ALTERNATES

- A. Alternate No. A-1: Entrance Door and Stair and Accessible Ramp Assembly
 - 1. Base Bid: Omit new stair and ramp assembly and new door 103..
 - 2. Alternate: Create new opening in masonry, install new frame and door assembly, and install new stair and accessible ramp assembly on the East elevation, as detailed in the drawings.

END OF SECTION 01 23 00